EQUIPMENT SCHEDULE

01-11-19

PLUMBING

FS INDIRECT CONNECTION TO FLOOR SINK
D DIRECT CONNECTION
RIH ROUGH IN HEIGHT (TO CENTER OF CONNECTION)

ELECTRICAL

D DIRECT CONNECTION
C CONVENIENT OUTLET
FSO FLOOR STUB OUT
DC DROPPED CORD

DESCRIPTION

O OWNER(PANDA EXPRESS, INC.)
GC GENERAL CONTRACTOR
EC ELECTRICAL CONTRACTOR
KEC KITCHEN EQUIPMENT COMPANY
S SERVING AREA
K KITCHEN
(E) EXISTING

SUPPLY BY	GAS K BTU	GAS R.I.H.	GAS SIZE	WASTE TYPE	WASTE SIZE	COLD WATER R.I.H.	COLD WATER SIZE	HOT WATER R.I.H.	HOT WATER SIZE	CONNECTION R.I.H.	CONNECTION TYPE	LOAD WATT	PHASE	H.P.	VOLTS	REMARKS	DIMENSIONS W x D x H (ø x H)	MANUFACTURE	MODEL #	EQUIPMENT	NO.
SERVING AREA EQUIPMENT																					
O																SEE DETAIL	SEE PLAN	KEC	CUSTOM	HOT WELLS COUNTER, SERVICE	1B
O																SEE DETAIL	SEE PLAN	KEC	CUSTOM	SNEEZE GUARD	1S2
O										REF. ELEC.	D	475W	1		120	3 HEATING ELEMENTS	42.375" X 4.25" X 2.375"	GENERAL		43" RADIANT TOP HEATER	1S2b1
O											D	625W	1		120	4 HEATING ELEMENTS	55.375" X 4.25" X 2.625"	GENERAL		56" RADIANT TOP HEATER (2)	1S2b2
O											D	475W	1		120	3 HEATING ELEMENTS	42 1/8"x4.25"x2 5/8"	GENERAL		43" RADIANT TOP HEATER (2)	1S2-S1d
O											D	15A	1		120	SEE DETAIL	SEE PLAN	KEC	CUSTOM	CASHIER & BEVERAGE. COUNTER	2Q
O											C	650W	1		120	INDUCTION WARMER	15 3/4" DIA	I/O CONTROLS CORP	ABC-065-14	INDUCTION WELL - 17QT	3F
O											C	650W	1		120	INDUCTION WARMER	12 1/8" DIA	I/O CONTROLS CORP	ABC-065-10	INDUCTION WELL - 11QT	3G
O				FS	3/4"						C	9.3A	1		120	W/LID DISPENSER	30"x30"x35"	CORNELIUS	IDC-255	BEVERAGE DISPENSER	4AB
O										66"	C	7.2A	1		120	ON S/S SHELF	15"x11"X16"	WELBILT	16-2172	BOOSTER	4B
O																	40"x18"	WELBILT	15-2903-IP	SODA RACK	4C
O																	#22"	ESPRIGAS	PER MFG	CO2 TANK	4D
O																		CO2Meter.com	RAD-0102-6	CO2 MONITOR & DISPLAY	4D-S1
O						96"	1/2"									WALL MOUNT	8"x2 3/8"x23 5/8"	3M WATER FILTRATION	BEV190-56164-01	WATER FILTER	4F
O				FS	1/2"												34"x17"x6 1/2"	KEC	CUSTOM	36" COLD PAN	5C
O																	SEE PLAN	KEC	CUSTOM	S/S COUNTER WITH SINK	6B
O										24"							SEE PLAN	KEC	CUSTOM	HOT WELLS COUNTER- DRIVE THRU	6F
O										24"							SEE PLAN	KEC	CUSTOM	CASHIER & BEVERAGE COUNTER- DT	9B
O										24"	C	14.8A	1		120	NEMA 5 PLUG	11" X 22" X 34"	BUNN	TB3	ICED TEA BREWER (2)	9D
O				FS	1/2"	24"	1/2"			84"	C	1.1A	1		120	----	22" X 14" X 26.5"	MANITOWOC	800 LBS. ICE MACHINE	10-B894YC	10J
O										16"	D	11.8A	1		208/230	ON ROOF	34"X 24.13"X 25.75"	MANITOWOC	CVD-0875	REMOTE CONDENSER	10J-S1
O													1		115	FREE STANDING	34" X 22" X 44"	MANITOWOC	IYT0620A	CUBER HALF DICE CUBE	10L
O													1		---	ABOVE ICE MACHINE	24"X 17.5"X 21.5"	MANITOWOC	D420	STORAGE BIN	10L-S1
KITCHEN EQUIPMENT																					
O	450	10"	1-1/2"	FS	2"	10"	1/2"									SEE DETAIL	93"x42"	KEC	CUSTOM	93" CHINESE RANGE (L)	20A
O	190	10"	1"	FS	2"	10"	1/2"									SEE DETAIL	42"x42"	KEC	CUSTOM	42" CHINESE RANGE	20Q
O	122 EA	14"	1 1/2"							24"	C	-	1		120		47"x31-1/2"x51-5/8"	FRYMASTER	MJ45-FPP345G	FRYER	21B
GRILL NEMA PLUG/CONNECTOR O	54	10"	3/4"														24"x31.5"x15.25"	VULCAN	MSA24-GO100P	24" GAS GRIDDLE	23E
										36"	C	17.3A	1		208		10.4"X22.9"	VULCAN	VMCS-101	(2) ELECTRIC GRIDDLE TOP	
O										24"	C	14.8A	1		120	NEMA 5	19.9"X34.5"X41.3"	WINSTON	HA4005	RICE HOLDING CABINET	24H
O	34.6	10" & 32"	3/4"														24"x19"x17"	PANTIN	CC-6100(N)	RICE COOKER	25A
O										24"	C	9A	1	1/2	115	NEMA 5-15P	60"X33"X36"	RANDELL	9205F-290	60" WORKTOP FREEZER	30L
O				FS	3/4"					130"	D	2.0AMPS	1	1.5	120/208		SEE PLAN	KEC	CUSTOM	WALK-IN COOLER UNIT	31
O											D	3120w/2	1	1.5	208		SEE PLAN	KEC	CUSTOM	WALK-IN COOLER COND.	31-S
O				FS	3/4"					130"	D	FREEZER FAN COIL UNIT POWERED FROM CONDENSER UNIT					SEE PLAN	KEC	CUSTOM	WALK-IN FREEZER	32
O											D	10.0A	1	1.5	208		SEE PLAN	KEC	CUSTOM	WALK-IN FREEZER COND.	32-S1
O											D/ID	500W	1		120		SEE PLAN	KEC	CUSTOM	W.I.F. LTG, DOOR HEATER	32-S7
O										24"	C	15A	1	1/2	120	SELF CONTAINED	84"x33"x35"	RANDELL	9050K-7MPR2-NSB	84" REF. PREP. TABLE	34O
O										24"	C	9A	1	1/3	120	SELF CONTAINED	48"x33"x35"	RANDELL	9030K-7	48" REF. PREP. TABLE	34D
O				FS	2"	14"	3/4"	14"	3/4"								100"X30"	KEC	CUSTOM-(PS-100L)	POT SINK	40A
O				FS	2"	14"	3/4"	14"	3/4"							1 COMPARTMENT	42"x30"	KEC	CUSTOM-(VS-42)	42" VEGETABLE SINK (R)	41B
O				FS	2"	14"	3/4"	14"	3/4"							1 COMPARTMENT	42"x30"	KEC	CUSTOM-(VS-42)	42" VEGETABLE SINK (L)	41C
O										18GA POLISHED (WALL MTD. @ 59" A.F.F.)							SEE PLAN	PANDA WAREHOUSE	CUSTOM (NSF)	12"D S.S. WALL MTD. SHELF	43A
O										18GA POLISHED (WALL MTD. @ 71" A.F.F.)							SEE PLAN	PANDA WAREHOUSE	CUSTOM (NSF)	18"D S.S. WALL MTD. SHELF	43B
O										4 SHELVES MTD. @ 8" A.F.F., 26" A.F.F., 54" A.F.F., 72" A.F.F.							SEE PLAN	GOLD BOND	ISS	18"D WIRE SHELVES	44A
O										UNDER CABINET SHELVES WITH CASTER MTD. @ 8" A.F.F., 20" A.F.F.							SEE PLAN	GOLD BOND	ISS	SHORT 18"D WIRE SHELVES	44A-U
O										4 SHELVES MTD. @ 36" A.F.F., 48" A.F.F., 60" A.F.F., 72" A.F.F.							SEE PLAN	GOLD BOND	ISS	24"D WIRE SHELVES	44C
O										UNDER CABINET SHELVES MTD. @ 8" A.F.F., 14" A.F.F.							SEE PLAN	GOLD BOND	ISS	SHORT 24"D WIRE SHELVES	44C-U
O																	24"x 30" x 24"	KEC	CUSTOM	S.S. RICE COOKER STAND	46A
O																	22"x 20" x 34.06"	KEC	CUSTOM	RICE WARMER STAND	46B
O																	36 1/2"x 33" x 26"	KEC	CUSTOM	S.S. GRILL STAND	46K
O																	18"x 33" x 30"	KEC	CUSTOM	STAND	46N
O										50"	C	10A	1	1	120	9 15/16"x19-11/16"x19-3/4"	ELECTROLUX	DITO-TRS24	FOOD PROCESSOR	53
SMALL EQUIPMENT																					
O					2"	24"	1/2"	24"	1/2"							W/TOWEL & SOAP	14 1/4"x18 1/2"	GSW	HS-1615NPASS	HAND SINK	45A
O										24"	C	105W	1		120	ON S.S. COUNTER	17" ø	WELBON	WRS-1088BS	RICE WARMER	54A
O										84"	DC	1800W	1		208	PLUG: NEMA 6-15R	17 1/2"x13 5/8"x22 9/16"	SHARP	R-CD1800M	MICROWAVE	55A
BY G.C.																AS REQUIRED BY LOCAL FIRE DEPT., CHECK LOCATION WITH PROJECT MANAGER				FIRE EXTINGUISHER	56
O																	SEE DETAIL	SAN-JAMAR	SANJT7500TBK	PAPER TOWEL DISPENSER	60D
O																WALL MOUNT	12"x20"x77"	GSW	5-DOOR	LOCKER (2)	61B
O																	20"X20"X23"	TIDEL	CUSTOM	SMART SAFE	62B
POS EQUIPMENT																					
O																SEE ELEV. ON E-200	48" X 28" X 42"	KEC	CUSTOM	MANAGER STATION	49A
O										REF ELEV	C	100W	1		120	SEE DETAIL		DELL OPTIPLEX	Xe2	COMPUTER	83A
O										REF ELEV	C	50W	1		120	SEE PLAN		BROTHER	MFC-LC2700DW	POS PRINTERS	86A
O										REF ELEV	C	50W	1		120			BROTHER	MFC-LC2700DW	FAX	87
										REF ELEV	C	500W	1		120	CUSTOM	11 1/4"x14 1/2"x9"	RESNOS	S 460	CASH REGISTER SYSTEM	94
O																					
MEP EQUIPMENT																					
O																SEE MECH. DWG.	SEE PLAN	CAPTIVE AIR	CUSTOM	EXHAUST HOOD	M1
O																SEE MECH. DWG.	SEE PLAN	CAPTIVE AIR	CUSTOM	HOOD CONTROL PANEL	M4
O																SEE MECH. DWG	SEE PLAN	CAPTIVE AIR		FIRE SUPPRESSION SYSTEM	M5
BY G.C.																SEE MECH/ELEC DWG	SEE PLAN			RECESSED ANSUL PULL BOX	M6
O										90"	D	5.1A	1	1/2	115	SEE MECH/ELEC DWG	42" X 10 5/8"	MARS	STD242-1U	BACK DOOR AIR CURTAIN	M8A
BY G.C.										24"	D	20A	1		120	SEE ELEC. DWG	25"X 9" X 10 3/8"	QUIK-SERV	CF-25 NON-HEATED	DT WINDOW AIR CURTAIN REGIONAL APPLICATION EITHER OR, NOT BOTH	M9a
BY G.C.										24"	D	30A	1		120 & 208	SEE ELEC. DWG	25"X 9" X 14 3/8"	QUIK-SERV	CHF-25 HEATED		
BY G.C.										24"	D	20A	1		120	SEE ELEC. DWG	47.5"X 59.5"	QUIK-SERV	SST-4860E	DT WINDOW	M10
BY G.C.				3"	36"	–	36"	–			D					FLOOR TYPE	24" X 24" X 13"	C.S.W. PHONE:1800-897-5999	SE2424FM	STAINLESS STEEL MOP SINK	P1
BY G.C.										84"	C	8A	1		120	SEE PLUMBING DWG	39" X 29.75" X 13"	RINNAI	MTG-00247	GAS TANKLESS WATER HEATER	P3 (2)
O										REF ELEV	C	50W	1		120	SEE ELEV. ON E-200	SEE PLAN	HYPERACTIVE		HYPERACTIVE TIMER SYS.	94-1A
O										48"	C	50W	1		120	SEE PLAN	15" X 13"	DELL (17" COLOR)		LCD MONITOR-MANAGER	94-2-16
O										REF ELEV	C	50W	1		120	SEE ELEV. ON E-200	SEE PLAN	HME		HME INTERCOM SYS.	94-3-1
O										REF ELEV	C	60W	1		120	SEE PLAN	15"	POSIFLEX	KS7215	LCD DT MONITOR	94-W
O										REF ELEV	C	50W	1		120	W/ EMI LOCK	SEE PLAN	TOSHIBA (TIME LAPSE)		SECURITY VCR	95-4-S2
O										98"	C	50W	1		120	SEE ELEC. DWG	15" X 13"	DELL (17" COLOR)		SECURITY MONITORS	95-4-S3
O										REF ELEV	C	100W	1		120	IN S.S. COUNTER	SEE PLAN			MUSIC EQUIPMENT	95-5
BY G.C.																SEE ELEC. DWG				ELECTRICAL PANEL	E7
SIGNAGE																					
O																	REF. INT. ELEV'S	LSI	CUSTOM	MENU BOARD	D2b
O																8F-POWER COAT "DF125 SILVER"		FAD	–	COMMUNITY BOARD	D3b
O										REF ELEV	C	130W	1		120	DEDICATED CIRCUIT	48.9" X 28.1" X 1.3"	LG	55W550BS-B	LCD DISPLAY MONITOR	96-3B
FURNITURE																					
																SEE PLAN		RICHFIELD	STRAIGHT-8F	SERVICE COUNTER	F1d
																SEE PLAN		RICHFIELD	RIGHT TETON BEIGE	BEVERAGE COUNTER	F2CR

* REFERENCE SHEET A-109 FOR FURNITURE CORE DRILL DIMENSIONS

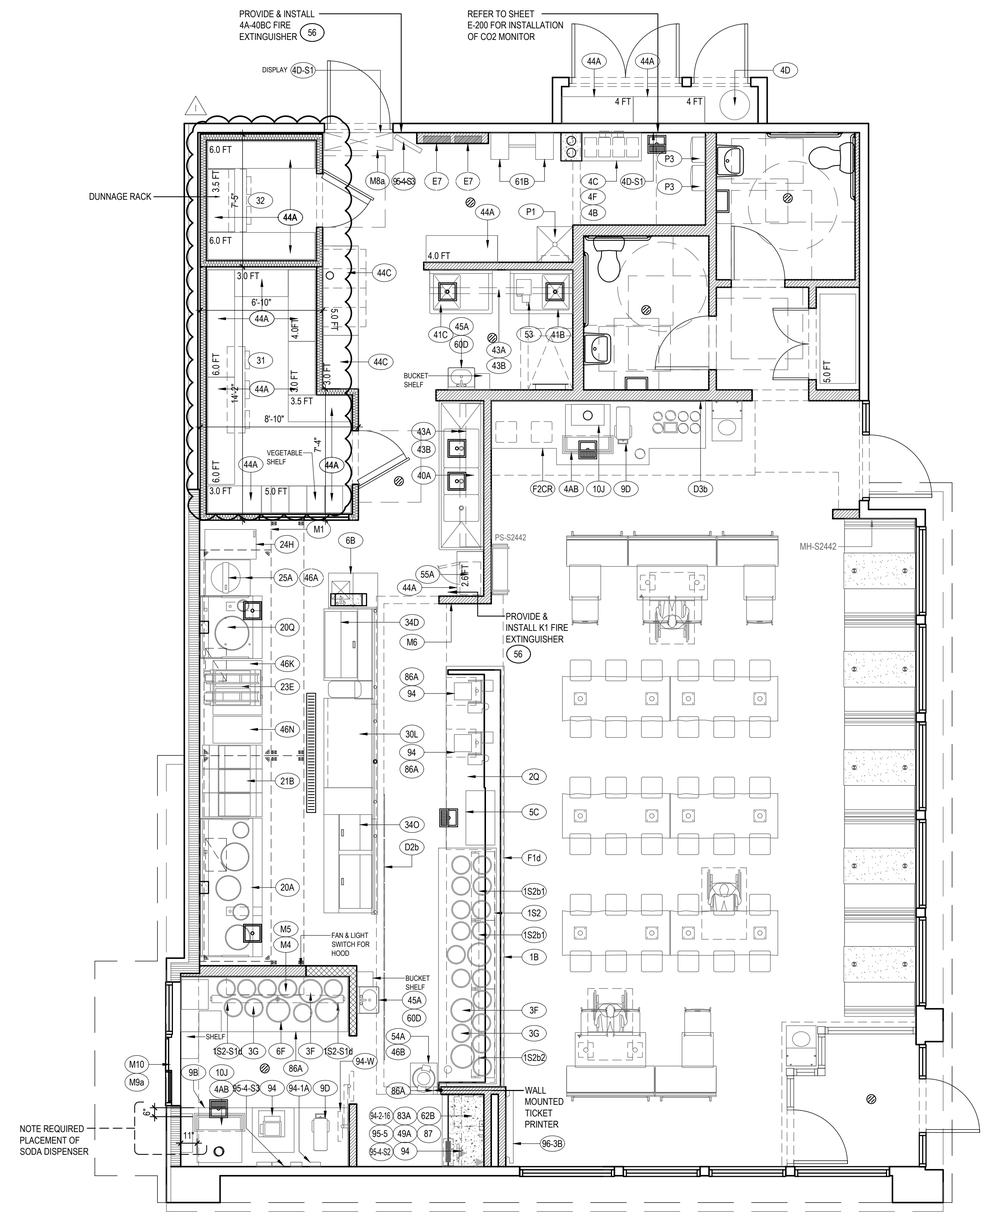

KITCHEN PLAN | 1
Scale= 1/4" = 1'-0" | A-101

PANDA EXPRESS, INC.
1683 Walnut Grove Ave.
Rosemead, California
91770
Telephone: 626.799.9898
Facsimile: 626.372.8288

All ideas, designs, arrangement and plans indicated or represented by this drawing are the property of Panda Express Inc. and were created for use on this specific project. None of these ideas, designs, arrangements or plans may be used by or disclosed to any person, firm, or corporation without the written permission of Panda Express Inc.

REVISIONS:

1	CITY COMMENTS	05.10.21

ISSUE DATE:

1ST	SITE PLAN REVIEW	02-16-21
2ND	PERMIT/BID SET	04-09-21

DRAWN BY: KB

PANDA PROJECT #: S8-22-D8193
PANDA STORE #: -
ARCH PROJECT #: 20044.021

STATE OF OHIO
HENRY C. KLOVER
19175
REGISTERED ARCHITECT
Henry Klover, License #9210175
EXPIRATION NOV 3 1 2021

khcloverarchitect
8813 PENROSE LANE, SUITE 400
LENEXA, KS 66219
ph: 913.649.8181 • fx: 913.649.1275

PANDA EXPRESS
TRUE WARM & WELCOME
1485 MAIN ST.
HAMILTON, OH 45013

A-101

KITCHEN PLAN